

AS-BUILT NARRATIVE

WASTE STORAGE 313: LEDGEVIEW FARM'S

Planning and design of a waste storage structure for Ledgeview Farm's started in 2009. Soil borings were conducted in 6-2009 and soils tested by AECOM. Adequate soil type and depth were found such that a structure could be sited and built to meet current NRCS Standards. In Fall of 2009 Ledgeview Farm's began logging and land grubbing the area. Preliminary design and plans were developed and collaborated with NRCS and DATCP. In 2010 Ledgeview Farms began stripping topsoil and had some clean clay (CL) fill hauled into the site from a construction project. Plans and specifications were revised and developed by Brown County LWCD on behalf of Ledgeview Farm's and were submitted and reviewed by DATCP. Plans and Specifications were approved by DATCP in 11/14. Plans were supplied to Ledgeview Farm's which they used to work on the site in varying degrees as they had time and equipment. Brown County assisted them in staking area extent for project location. Plans and specifications were submitted to WDNR 4/2015. Plans were reviewed and met current standards but, a failure analysis was required to complete the review. A failure analysis response was sent but, more information was requested. The plans were withdrawn until the needed data could be gathered and submitted.

Ledgeview Farms acquired some scrapers for their large tractors and began taking on more earth moving duties between planting and hay harvesting. July 8th, 2015 (b) (6)(b) (6) lost control of a tractor and scraper he was operating and tipped over in the excavation. (b) (6)(b) (6)(b) (6)(b) (6)(b) (6) The (b) (6) family was devastated with such a tragedy and with their connection to the community, hundreds of people shown interest and dozens gathered to help the family farm remain operational while immediate family attended to a more important matter. Several excavation company's and contractors donated heavy equipment and time working with and directing excavation activities for the waste transfer and waste storage facility. The structures transfer pipe and filling/grading was completed over a weekend. Several concrete contractors volunteered their time and equipment working with and directing volunteers in building a reception tank and concrete slab for the manure storage facility. These activities happened in just several days and were done by 8/15.

Brown County was contacted and conducted on-site inspections of equipment, materials and methods of excavation for the compaction of transfer pipe and storage facility. Brown County conducted inspection of sub-base foundations, forming, materials and curing for concrete tank and storage slab. Brown County put together an after-the-fact plan showing the transfer system. The structures sat for several months while Ledgeview Farms worked on harvesting crops, new milking parlor project and installing a pump in the reception tank. During this time Brown County developed further information for failure analysis and this was submitted to WDNR in 9/15. The structures clay liner testing was conducted by River Valley Testing and results show it meets NRCS 313 and WCS 300. An As-Built Plan was developed by Brown County documenting construction activities to ensure structures substantially met approved plan and applicable standards required by Brown County Animal Waste Ordinance.

Please refer to inspection plan, attached pages and documents to this plan for As-Built information.

Waste Storage Facility 313 (As-Built):

M.O.L 803.0 - Post installed with sign showing location and elevation of post on side slope is the
M.O.L elevation of 803.0
M.O.L Volume - 4,460,399 Gallons
Total Volume - 5,720,644 Gallons
Safety Volume above M.O.L - 1,260,245 Gallons
As-Built capacity exceeds 180 storage requirement calculated in attached design of 3,696,461 gallons.

Waste Transfer 634 (As-Built):

Two celled concrete tank was a design developed by NRCS and sited by Brown County.
Wet Cell - 12'Wx10'Lx8'D
Dry Cell - 12'Wx16'Lx8'D
Pumped Transfer Pipe - 12" D2241 SDR 21 PVC - 233' (Hydraulic piston pump)
Gravity Drain Transfer Pipe (future parlor waste) 6" D1785 SCH 40 - 233' + routed to parlor in barn by owner and parlor designer. In trench next to 12" pvc.

BCLWCD

BROWN COUNTY LAND & WATER CONSERVATION DEPT.

AB-CONSTRUCTION NOTES

CLIENT: Ledgeview Farms


COUNTY: BROWN

Date _____
Designed _____
Drawn _____
Checked _____
Approved _____

Drawing Name _____

Date
3/16

Sheet of

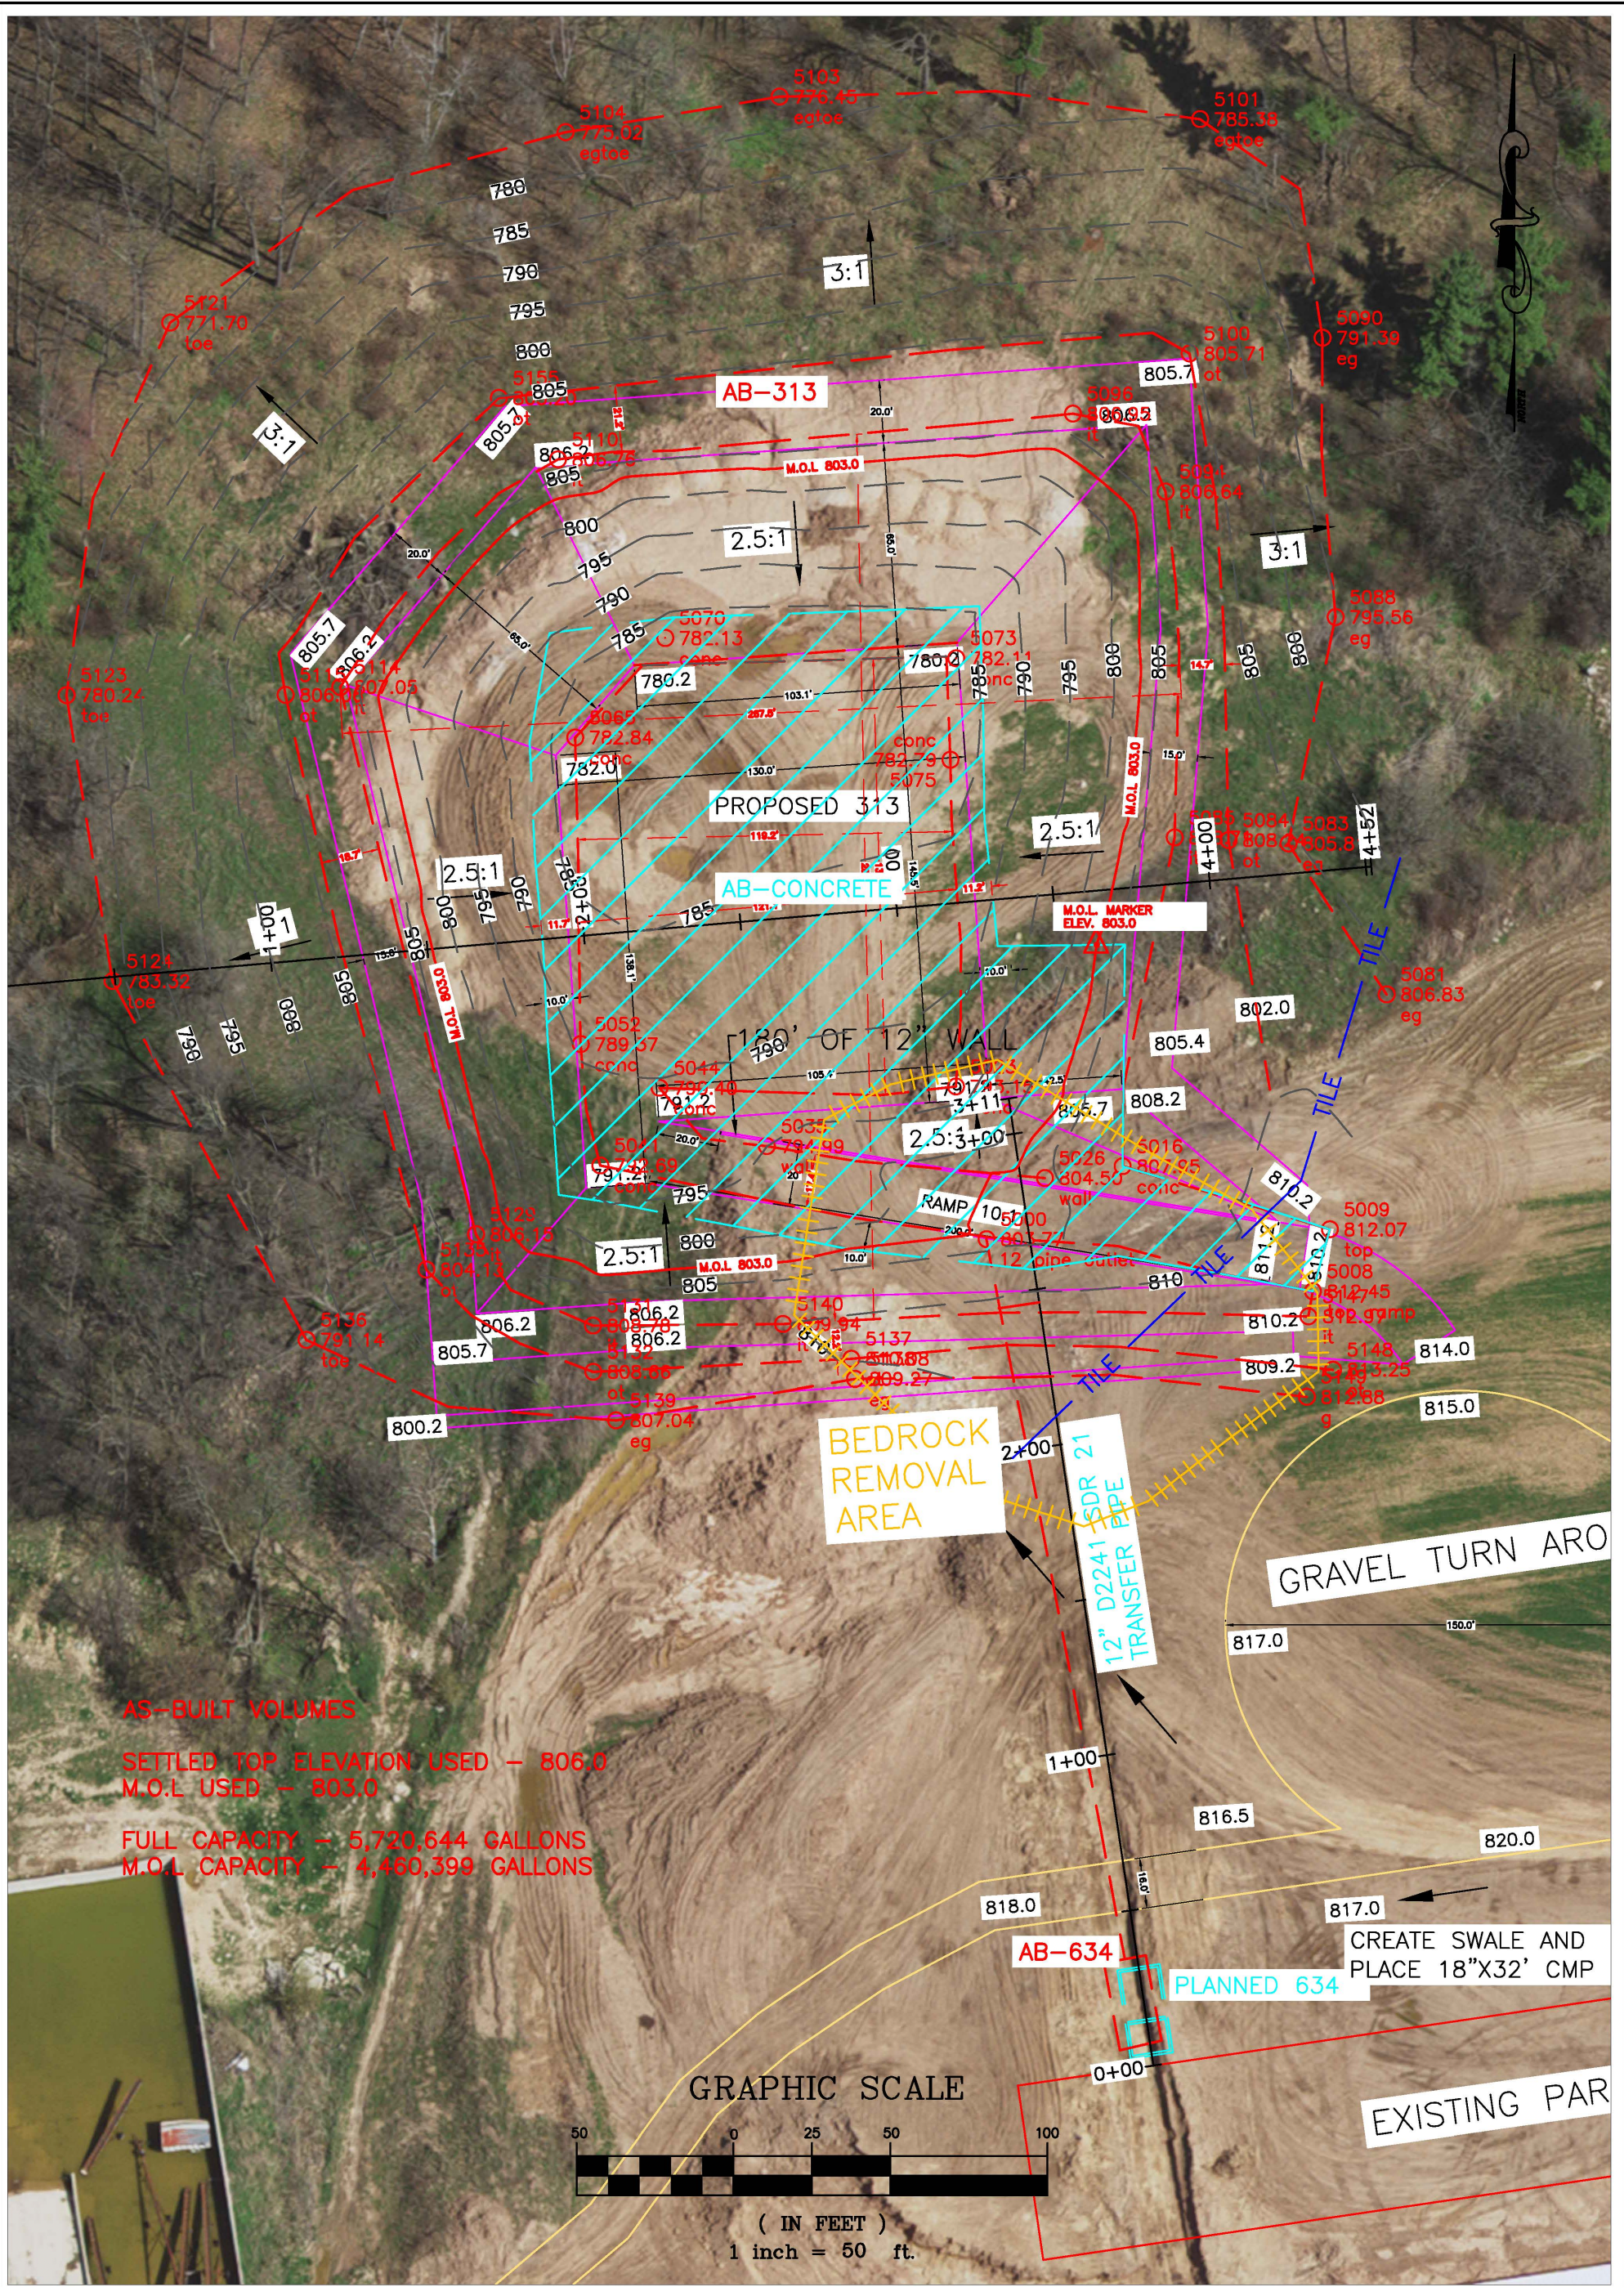


AS-BUILT VOLUMES

SETTLED TOP ELEVATION USED - 806.0
M.O.L. USED - 803.0

FULL CAPACITY - 5,720,644 GALLONS
M.O.L. CAPACITY - 4,460,399 GALLONS

GRAPHIC SCALE

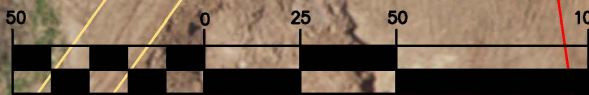

(IN FEET)
1 inch = 50 ft.


BCLWCD

BROWN COUNTY LAND & WATER CONSERVATION DEPT.

AB-PLAN VIEW

OWNER: LEDGEVIEW FARMS
COUNTY: BROWN



Designed	DLW	Date	3/16
Drawn			
Checked			
Approved			

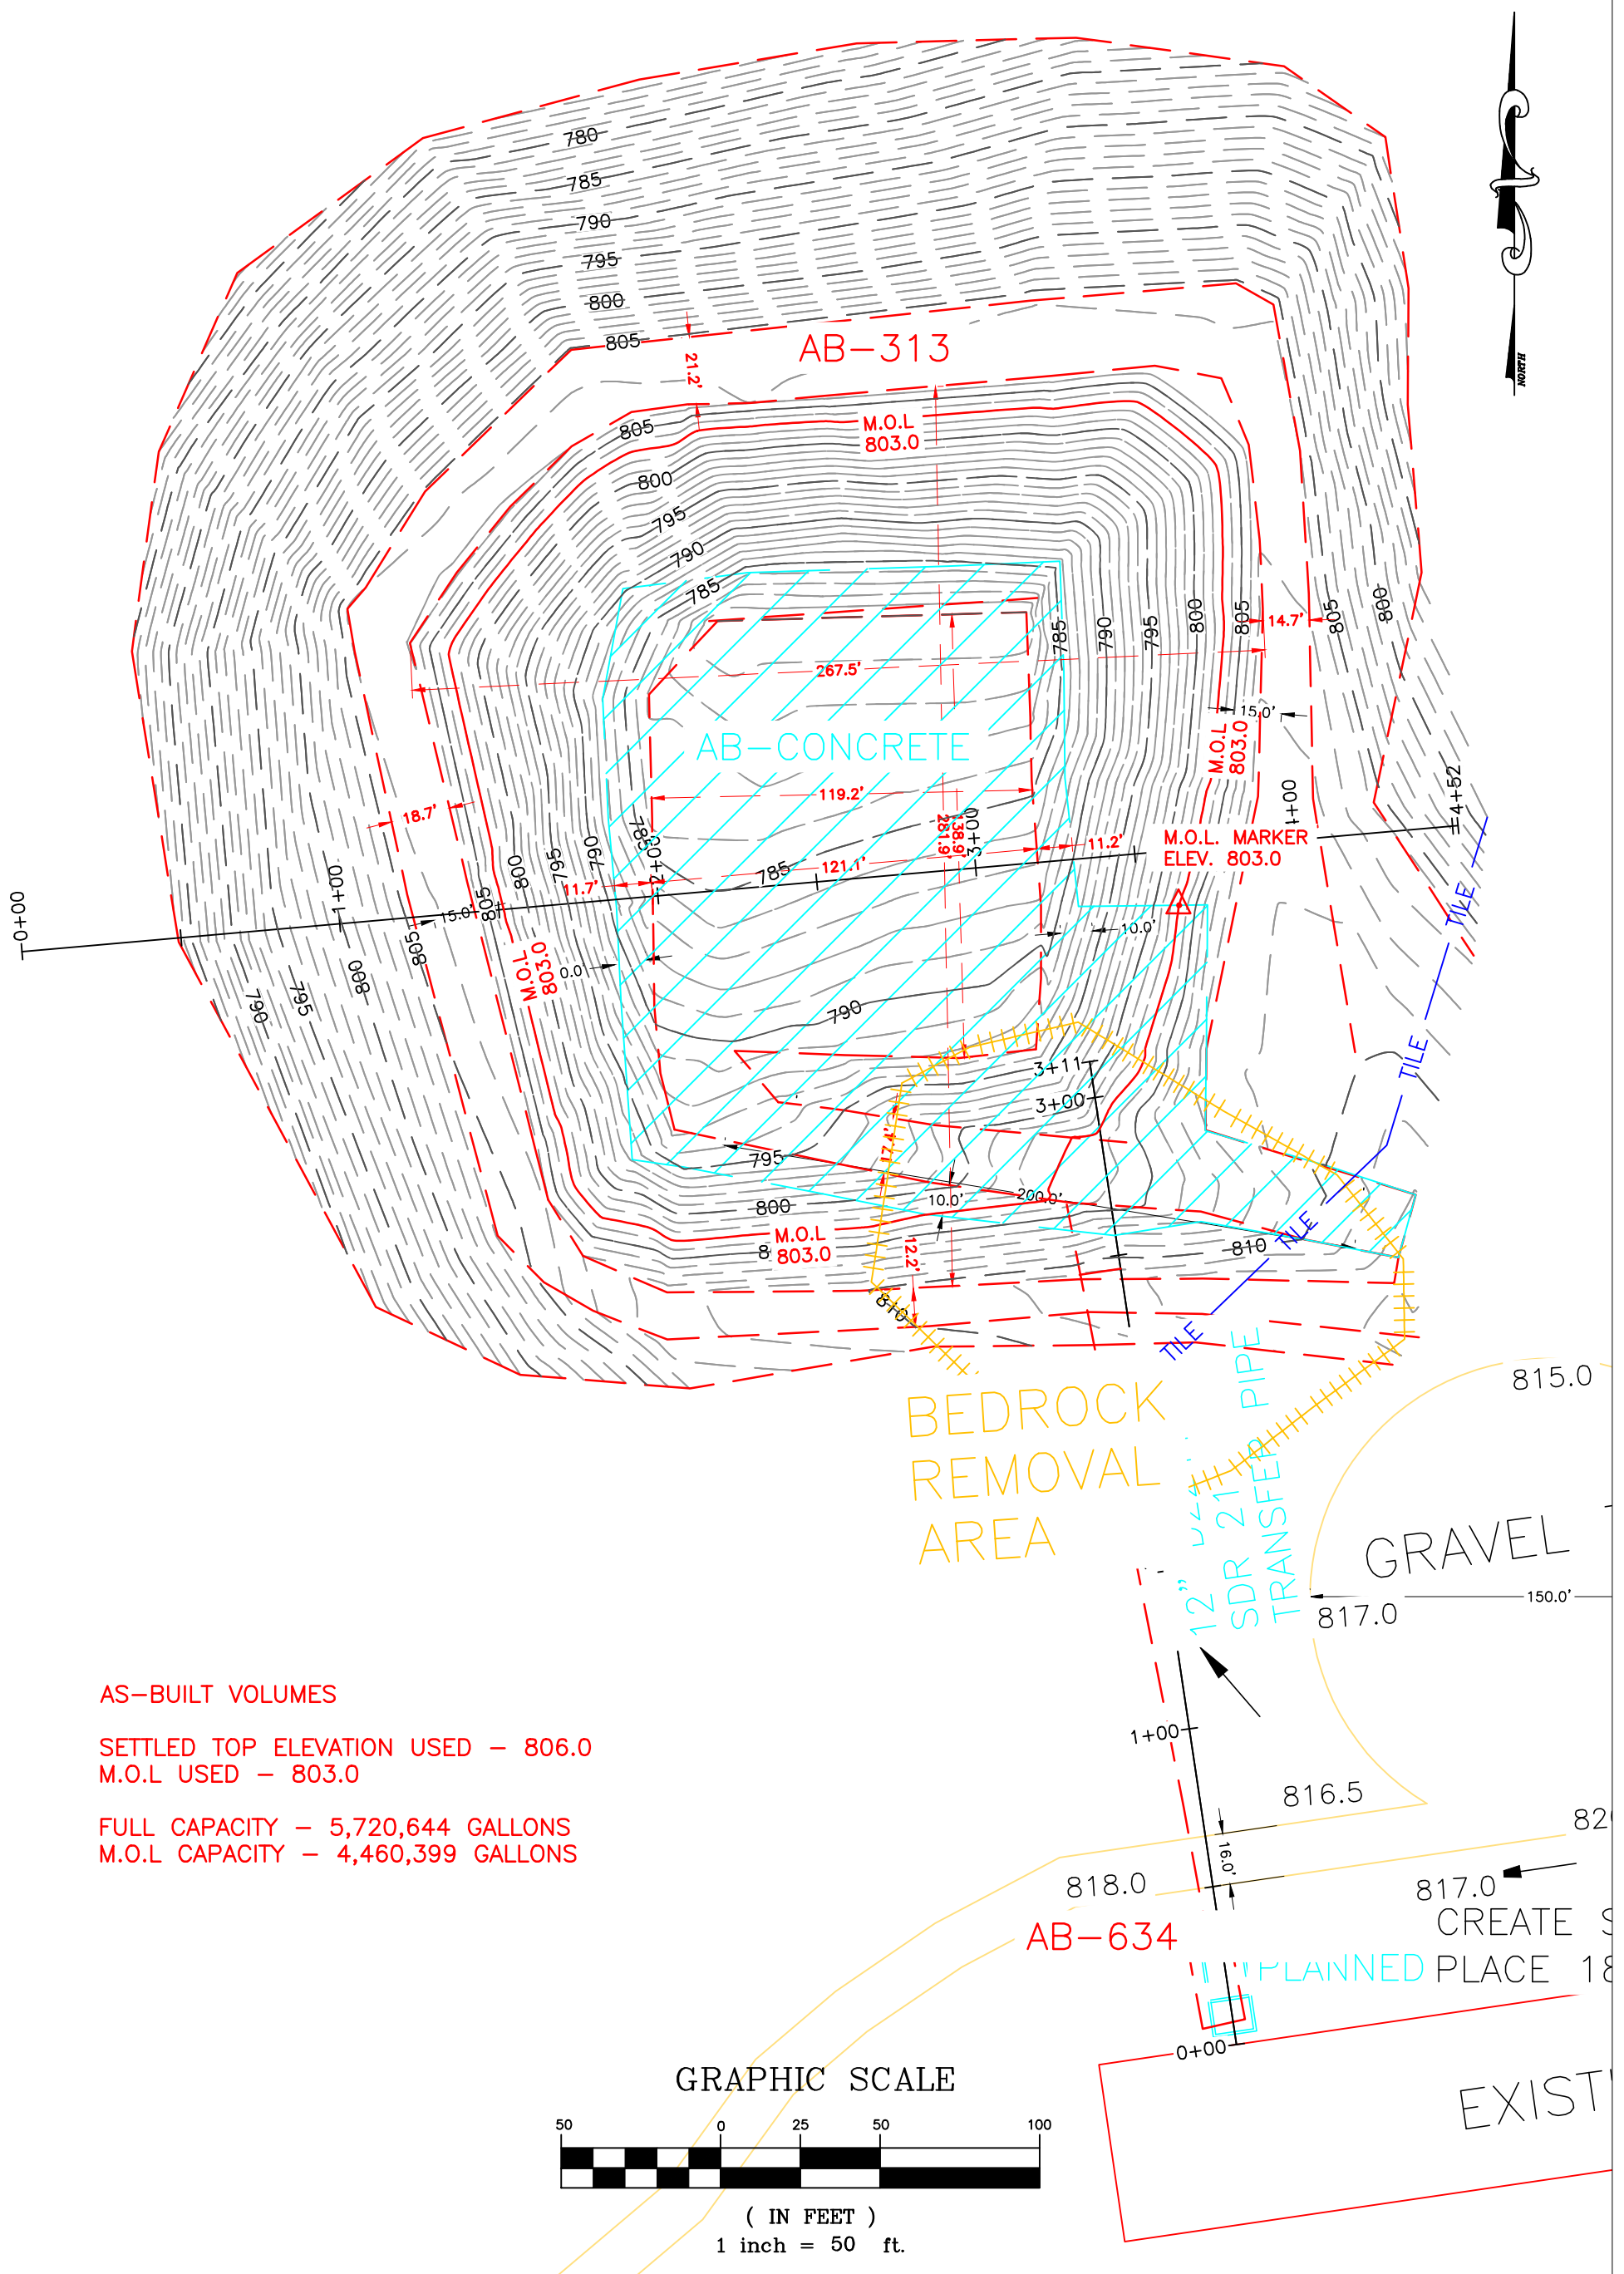

AS-BUILT VOLUMES

BCLWCD

Drawing Name
WI-006
Date
2016
Sheet ___ of ___

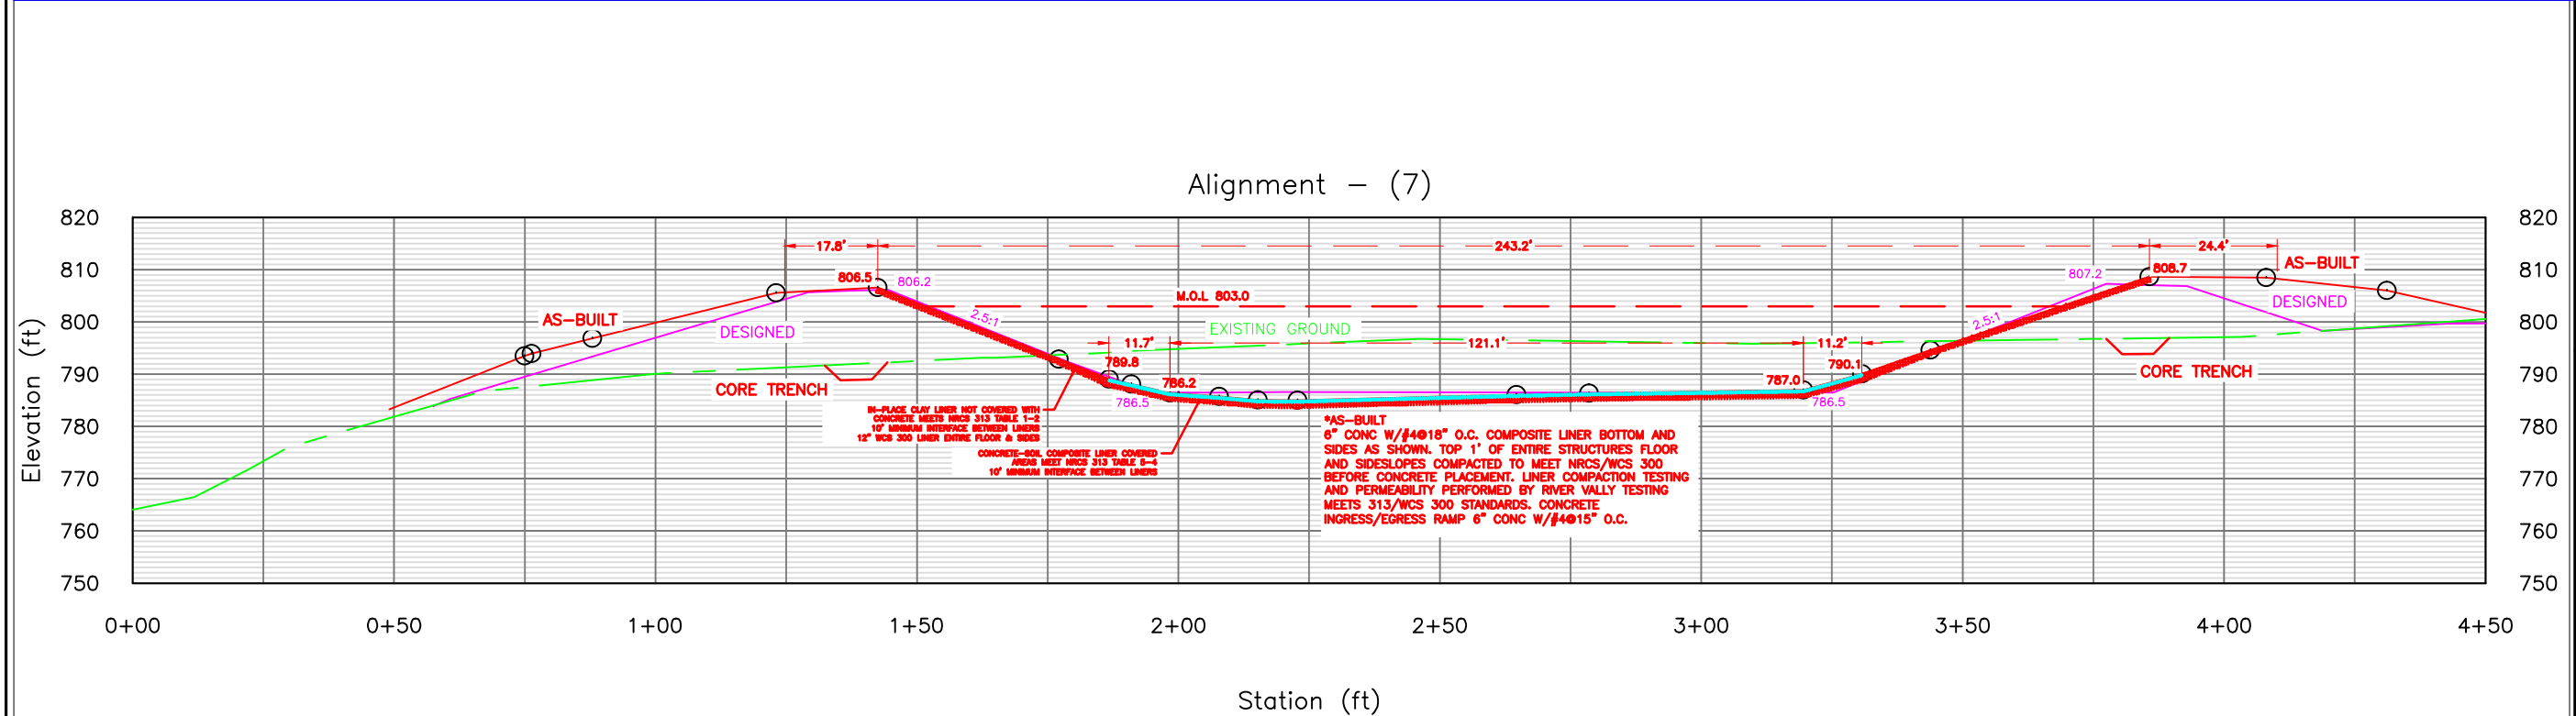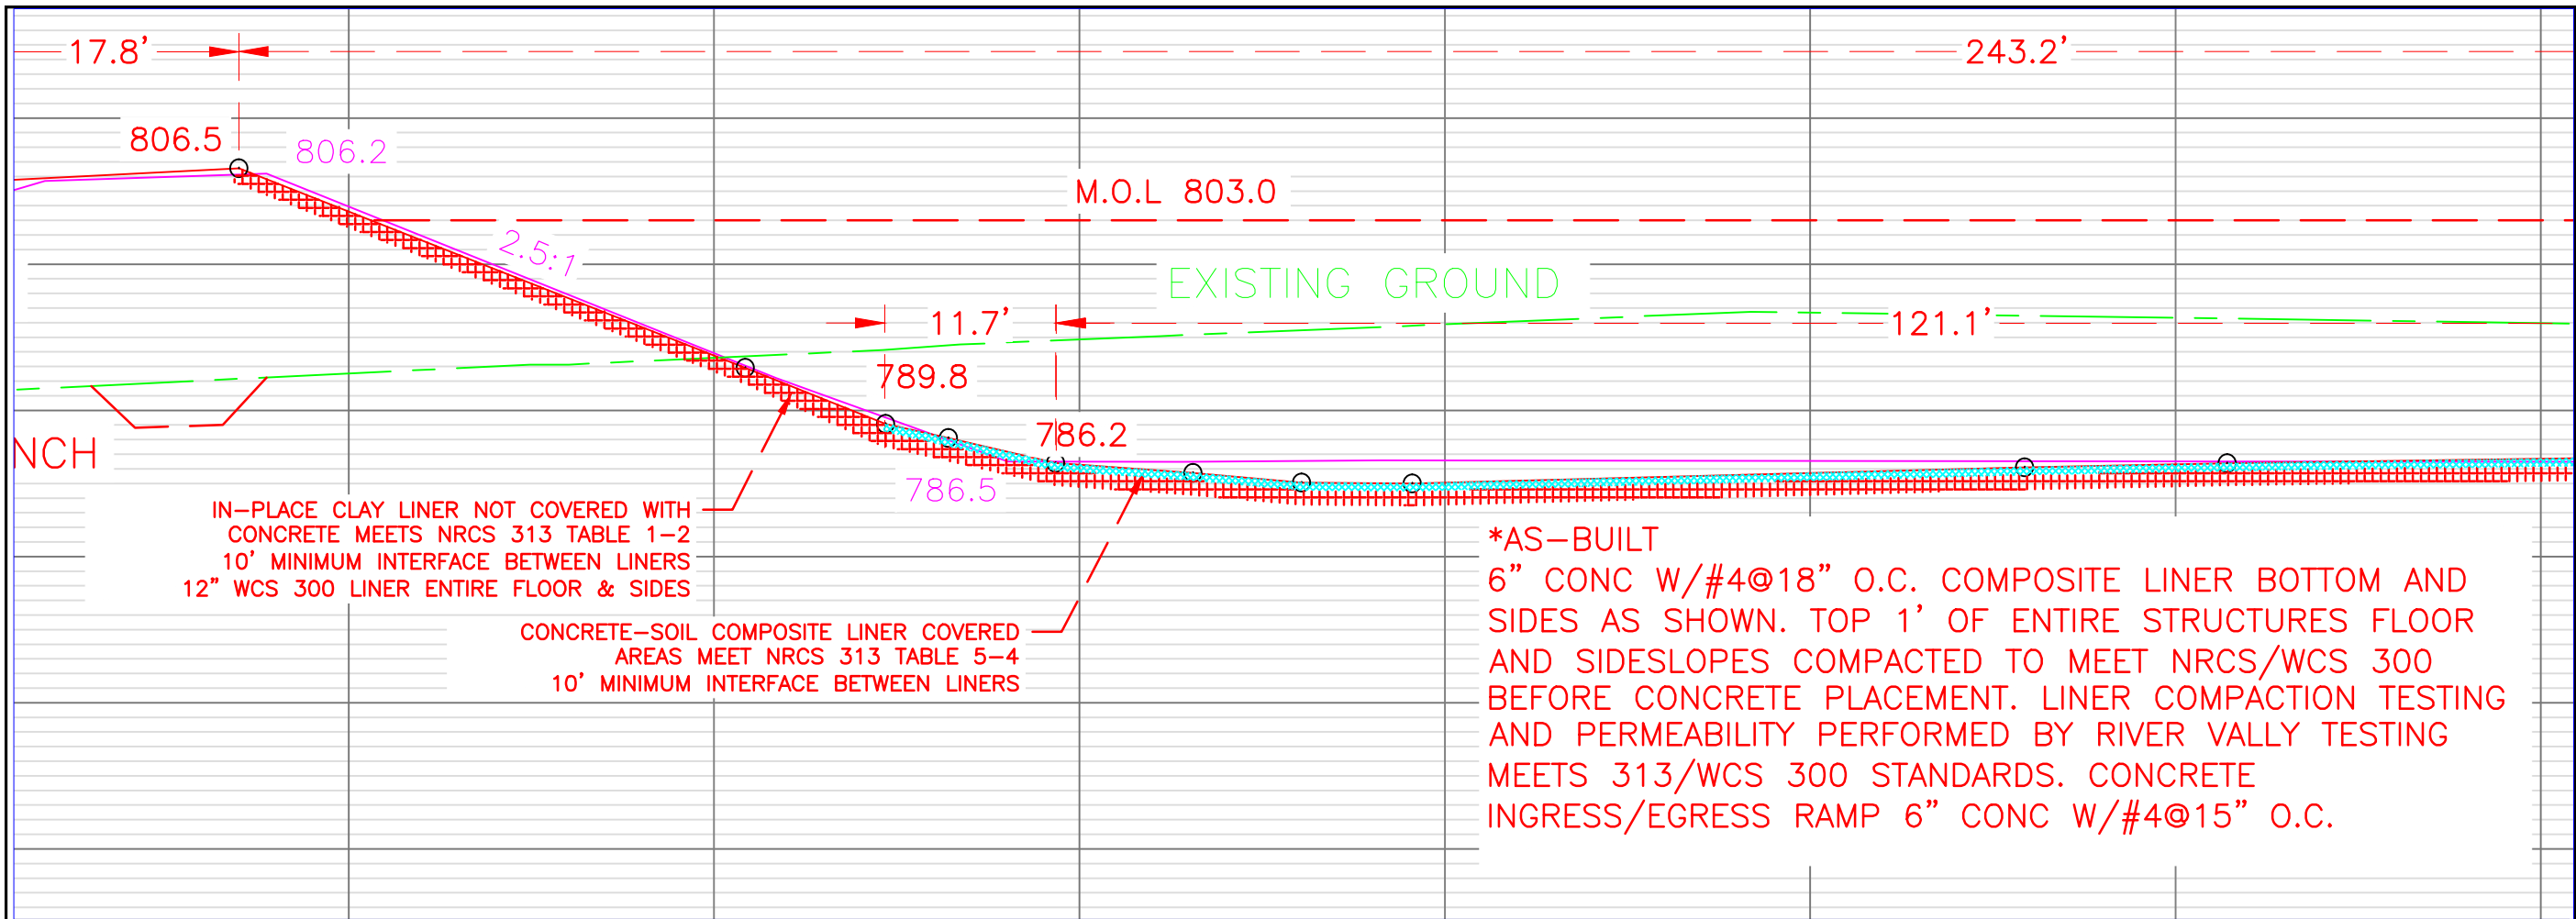


Date	_____
Designed	_____
Drawn	_____
Checked	_____
Approved	_____

AB-PROFILE VIEW

OWNER: LEDGEVIEW FARM'S, LLC

COUNTY: BROWN

BCLWCD BROWN COUNTY LAND & WATER CONSERVATION DEPT.	
	Drawing Name WI-006
	Date _____
Sheet ____ of ____	


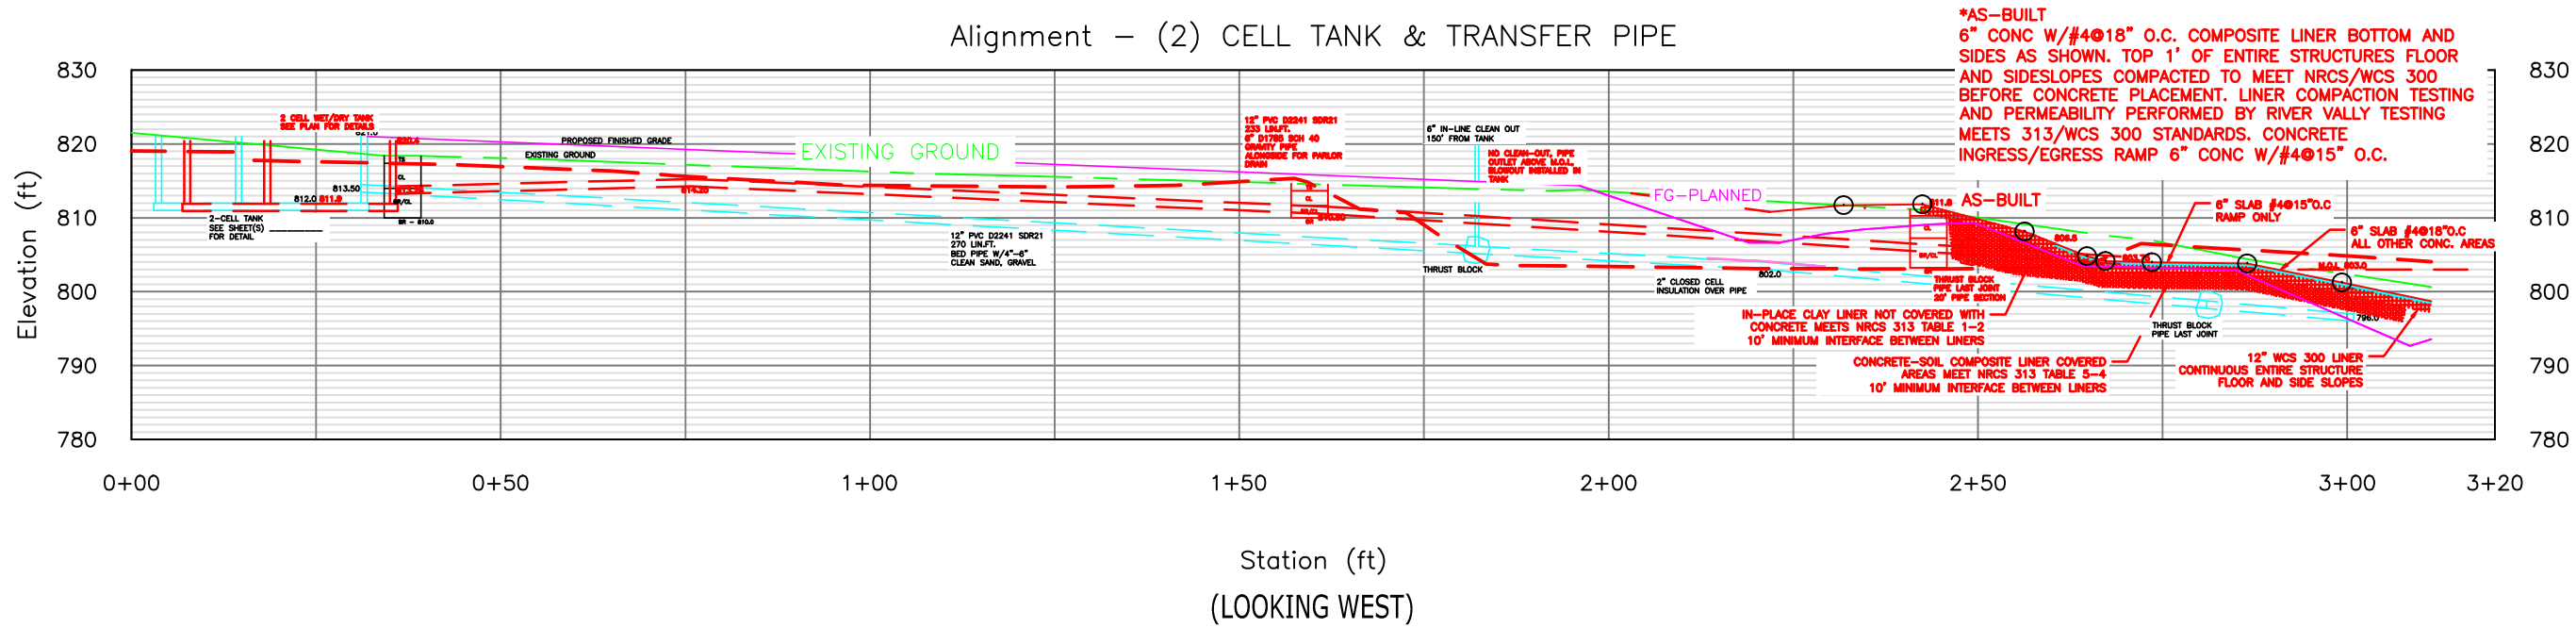


Date	_____
Designed	_____
Drawn	_____
Checked	_____
Approved	_____

PROFILE (AS-BUILT)

OWNER: LEDGEVIEW FARM'S, LLC

COUNTY: BROWN

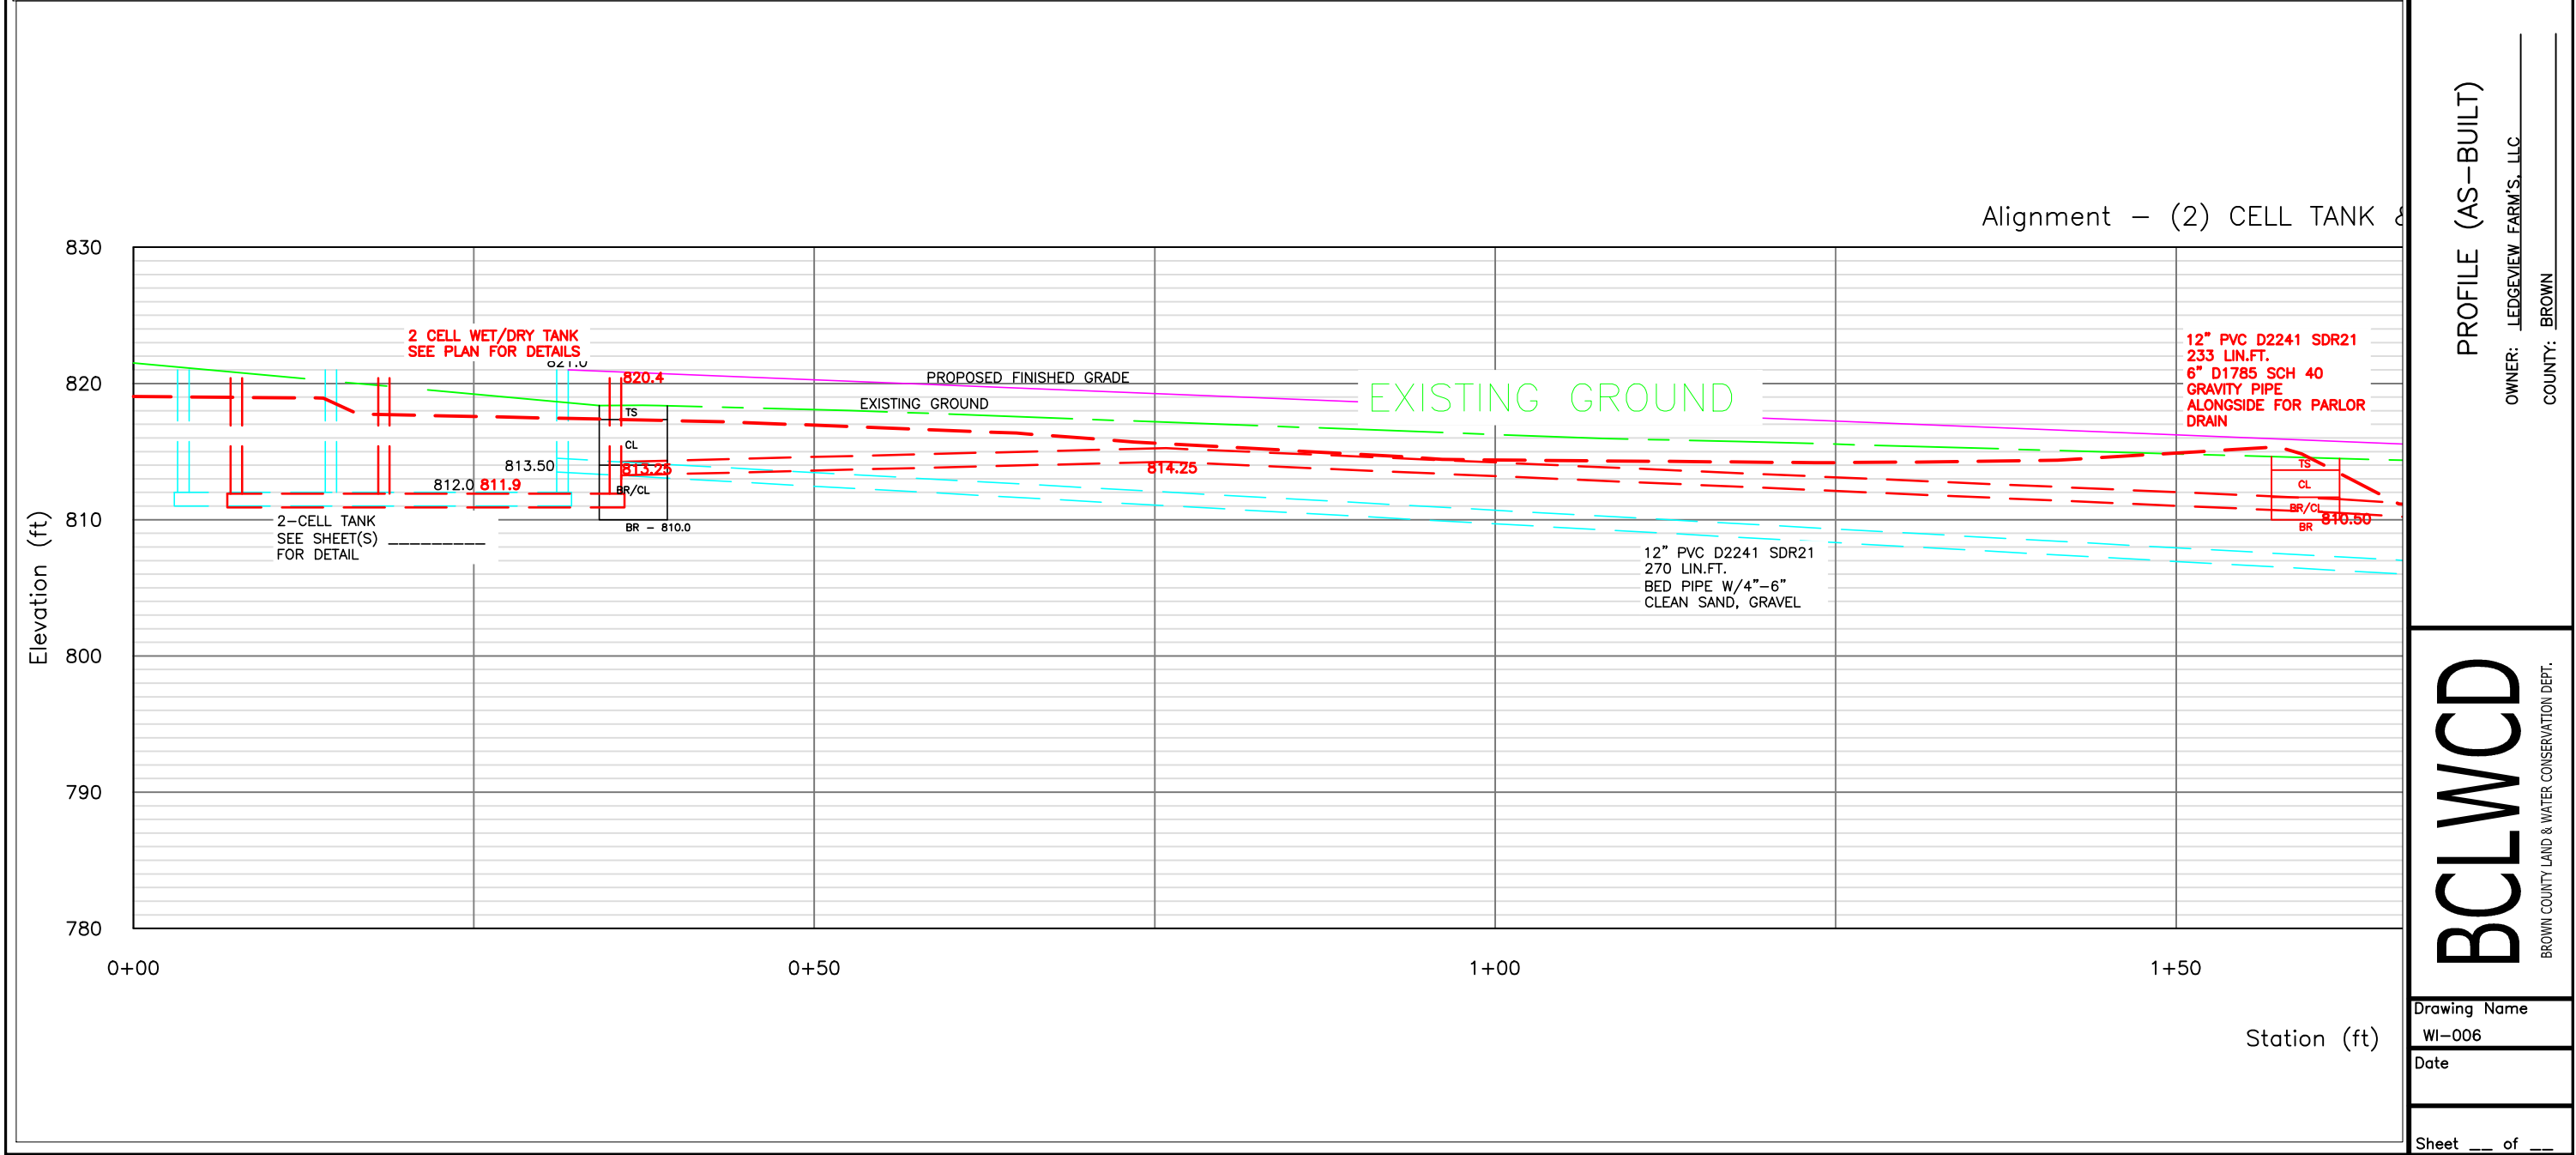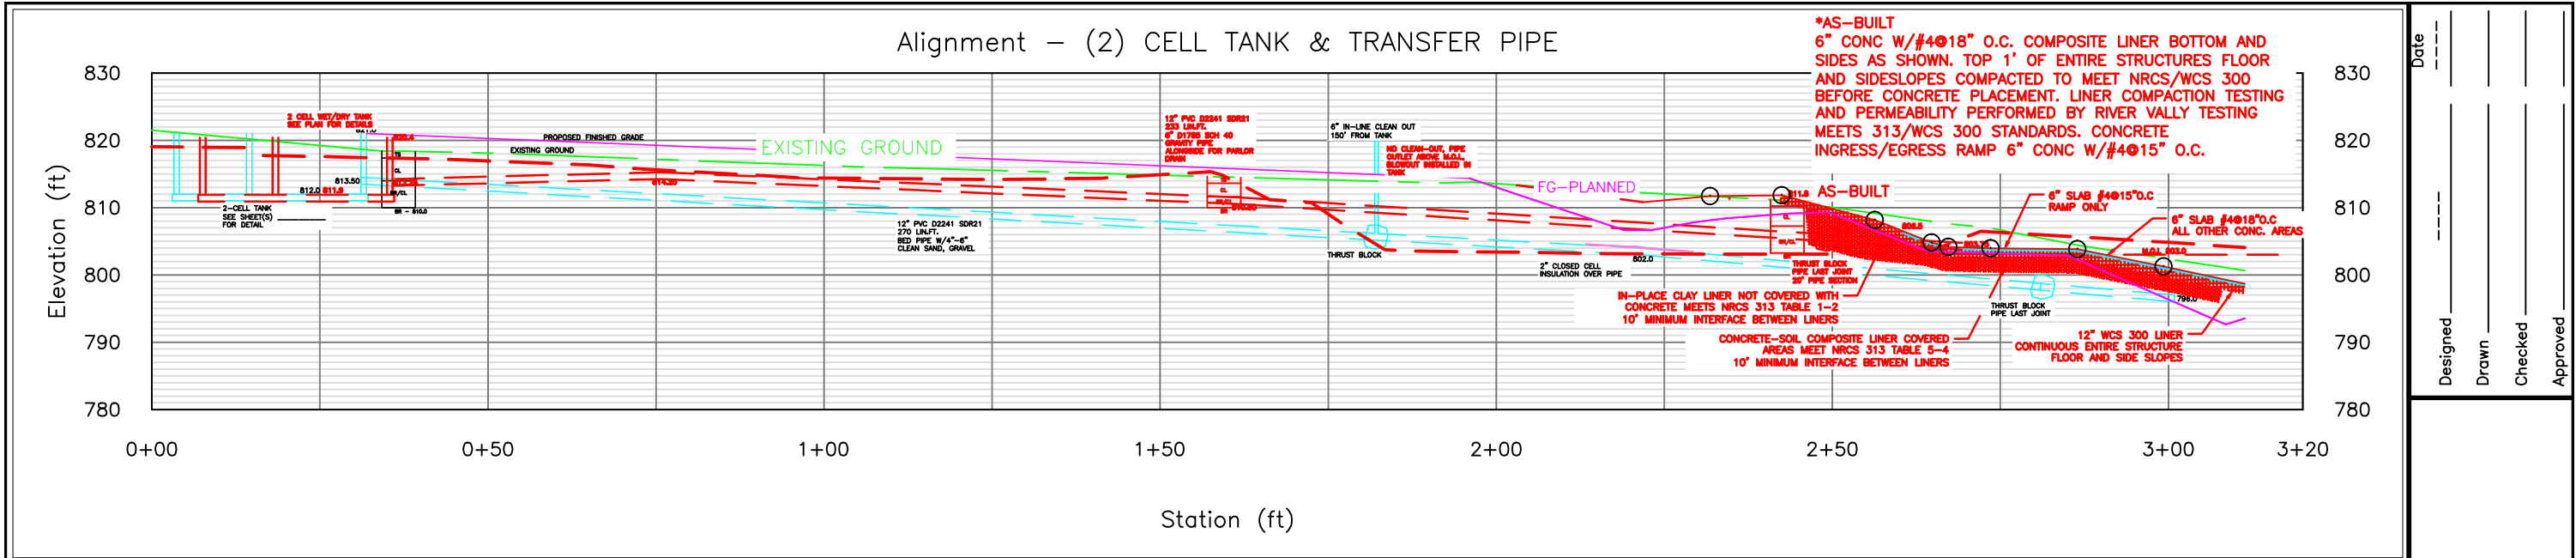

Date _____

Designed _____

Drawn _____

Checked _____

Approved _____

PROFILE (AS-BUILT)

OWNER: LEDGEVIEW FARM'S, LLC

COUNTY: BROWN

BCLWCD

BROWN COUNTY LAND & WATER CONSERVATION DEPT.

Drawing Name
WI-006

Date _____

Sheet ____ of ____

Concrete Mixes Reviewed by NE Area Office								UPDATED: 01/28/14
SUPPLIER	MIX #	CEMENT, lbs	FLY ASH, lbs	SLAG, lbs	WATER, gal	W/C RATIO	3/4" STONE, lbs	SAND, lbs
Biehl Redi-Mix	NRCS 2012-1A	423	-	141 (25%)	29.0	0.43	1,800 (57%)	1,370 (43%)
Carew Concrete - Appleton, Green Bay, Oshkosh, New London, Waupun, Horicon, Cooperstown, Portage, Green Lake, Waupaca, Algoma and Fond du Lac Plants	4000680036	395	-	169 (30%)	30.5	0.45	1,835 (58%)	1,309 (42%)
	4010610016	508	56 (10%)	-	30.5	0.45	1,835 (58%)	1,309 (42%)
	4010610036	508	56 (10%)	-	30.5	0.45	1,835 (58%)	1,309 (42%)
	4010610096	508	56 (10%)	-	30.5	0.45	1,835 (58%)	1,309 (42%)
	4025610016	423	141 (25%)	-	30.5	0.45	1,835 (58%)	1,309 (42%)
	4025610036	423	141 (25%)	-	30.5	0.45	1,835 (58%)	1,309 (42%)
	4025610096	423	141 (25%)	-	30.5	0.45	1,835 (58%)	1,309 (42%)
	5010610016	592	66 (10%)	-	33.0	0.42	1,817 (60%)	1,176 (40%)
	5010610036	592	66 (10%)	-	33.0	0.42	1,817 (60%)	1,176 (40%)
	5010610096	592	66 (10%)	-	33.0	0.42	1,817 (60%)	1,176 (40%)
	5025610016	494	164 (25%)	-	33.0	0.42	1,817 (60%)	1,176 (40%)
	5025610036	494	164 (25%)	-	33.0	0.42	1,817 (60%)	1,176 (40%)
	5025610096	494	164 (25%)	-	33.0	0.42	1,817 (60%)	1,176 (40%)
	NRCS-410 (has superplasticizer)	508	56 (10%)	-	30.5	0.45	1,835 (58%)	1,309 (42%)
	NRCS-425 (has superplasticizer)	423	141 (25%)	-	30.5	0.45	1,835 (58%)	1,309 (42%)
	NRCS-45A (has superplasticizer)	395	113(20%)	56(10%)	30.5	0.45	1,835 (58%)	1,309 (42%)
	NRCS-525 (has superplasticizer)	494	164(25%)	-	34.0	0.43	1,817 (60%)	1,176 (40%)
County Materials Corp.	55NRCS1	564	-	-	30.0	0.45	1,835 (58%)	1,307 (42%)
	55NRCS2	451	113 (20%)	-	30.0	0.45	1,825 (58%)	1,300 (42%)
	NRCS #2 - Hartford Plant	424	140 (25%)	-	30.5	0.45	1,780 (57%)	1,340 (43%)
	NRCS-2 Beaver Dam Plant	424	140 (25%)	-	30.5	0.45	1,770 (56%)	1,400 (44%)
Fels Ready Mix	NRCS	396	56 (10%)	112 (20%)	30.5	0.45	1,830 (55%)	1,490 (45%)
R & J Fricke Inc.	NRCS	455	-	110 (20%)	30.0	0.44	1,860 (55%)	1,500 (45%)
4X Concrete (Oshkosh, Brillion and Greenbush Plants)	#718	396	141 (25%)	28 (5%)	28.0	0.42	1,850 (60%)	1,250 (40%)
Gillett Cement Products	NRCS12	395	141 (25%)	28 (5%)	30.3	0.45	1,778 (57%)	1,336 (43%)
Green & Gold Cement Products	#50	480	84 (15%)	-	23.0	0.4	1,825 (55%)	1,475 (45%)
Harvey Co., Inc.	NRCS-1	564	-	-	30.5	0.45	1,802 (57%)	1,373 (43%)
	NRCS-2	474	90 (16%)	-	30.5	0.45	1,802 (57%)	1,363 (43%)
Lycon, Inc	65656827SCS	400	-	165 (29%)	30.0	0.44	1,760 (56%)	1,380 (44%)
	95656027	470	100 (18%)	-	29.0	0.42	1,756 (57%)	1,347 (43%)
	35646007	564	-	-	30.0	0.44	1,756 (56%)	1,368 (44%)
Marinette Concrete Products - Marinette Plant	NRCS12	395	141 (25%)	28 (5%)	30.3	0.45	1,740 (56%)	1,343 (44%)
Marinette Concrete Products - Pound Plant	NRCS12	395	141 (25%)	28 (5%)	30.3	0.449	1,740 (56%)	1,342 (44%)
MCC, Inc. - Appleton, Bonduel, Chilton, Crivitz, Depere and New London Plants	#138	564	-	-	30.5	0.45	1,800 (56%)	1,400 (44%)
	#602	423	141 (25%)	-	29.5	0.44	1,800 (57%)	1,380 (43%)
	#4138	400	-	165 (29%)	30.5	0.45	1,800 (56%)	1,390 (44%)
	#4602	394	85 (15%)	85 (15%)	29.5	0.44	1,800 (57%)	1,380 (43%)
Middle Inlet Concrete	NRCS12	395	141 (25%)	28 (5%)	30.3	0.45	1,740 (56%)	1,342 (44%)
Peters Concrete Co.	NRCS	423	141 (25%)	-	30.0	0.44	1,779 (58%)	1,288 (42%)
Premier Concrete	94000 Grade A-S	395	-	170 (30%)	30.6	0.45	1,909 (61%)	1,218 (39%)
	94000 Grade A-S	395	-	170 (30%)	28.5	0.42	1,937 (61%)	1,236 (39%)
	94000 Grade A-S w/ super	395	-	170 (30%)	27.1	0.40	1,956 (61%)	1,248 (39%)
Red-D-Mix Concrete, Inc.	NRC-2	494	70 (12%)	-	30.5	0.45	1,790 (56%)	1,432 (44%)
	NRC-2 w/ Super	494	70 (12%)	-	30.5	0.45	1,790 (56%)	1,432 (44%)

Project ID

Contractor

FRED FELS READY MIX
MARIBEL, WI 54227

Date

7-20-15

Plant

Vehicle No.

Load No.

Cubic Yards

Bag

on 2

41

2

93 3/4

60

packed at

Type

Brand

Oz./100 lb. of Cement

Catex 360AE

Sika

102

2000 N

Sika

402

Cement 396

Slag 112

Fly 56

At Plant

At Job Site

Actual Total

Allowable Total

20

MIXING REVOLUTIONS

At Plant

At Job Site

Total

50

Time of ~~Start~~ Started

Inspected by

Time Unloaded

Accepted by

Sand 1532

Stone 1800

	A	B	C	D	E	F	G
1	Concrete Mixture and Materials Information: Wisconsin Job Sheet 813						
2	Project:	634/313					
3	Contractor:	Ledgewiew Farms					
4	Concrete Manufacturer:	Fels Ready Mix		NRCS			
5	Mix Designed By:	Fels		Fred Fels			
6	Design Mix (Cubic Yard Basis)						
7	Cement [lb]					396	
8	Pozzolan Fly Ash [lb]					56	
9	Ground Granulated Blast Furnace (GGBF) Slag [lb]					112	
10	Measured Air Content [%] (Must be 6 ± 1.5)					6.0	
11	Measured Slump [in] (Must be 4-5)					5.0	
12	Measured Slump (After superplasticizer) [in] (Must be 4-6)						
13	28-Day Compressive Strength [psi] (Must be ≥ 3500 psi)						
14	Total Pozzolan + GGBF Material [lb]						
15	Total Cementitious Material [lb] (Cement + Pozzolan + GGBF)					564	
16	Pozzolan to Total Cementitious Material Ratio (Must be ≤ 0.25)					0.10	
17	GGBF to Total Cementitious Material Ratio (Must be ≤ 0.30)					0.20	
18	(Pozzolan + GGBF) to Total Cementitious Material Ratio (Must be ≤ 0.30)					0.30	
19	Total Cementitious Material per yd³ (Cement + Pozzolan + GGBF) (Must be ≥ 558.4)					564	
20	Water [gal]					20	
21	Fine Aggregate [lb]	1532		Moisture Content [%]			
22	Water Weight [FA]	61.28 lb.				7.35 gal	
23							
24							
25	Coarse Aggregate [lb]	1800		Moisture Content [%]		1	
26	Water Weight [CA]	18 lb.				2.16 gal	
27	Total Water Content [gal]					29.5059952	
28							
29	Oven Dry Fine Aggregate Weight [lb]					1470.72	
30	Oven Dry Coarse Aggregate Weight [lb]					1782	
31	Total Oven Dry Aggregate Weight [lb]					3252.72	
32	Fine Aggregate (Oven dry)/Total Aggregate (Oven Dry) (Must be 0.30-0.45)					0.452	
33							
34	Total Water Weight [lb]					246.08	
35	Water:Cement Ratio					0.436	
36	Materials						
37	Attach Sieve Analysis						
38	Fine Aggregate ASTM C-33	Size Number:					
39	Coarse Aggregate ASTM C-33	Type:				Brand Name:	
40	Air Entraining Agent ASTM C-260	Type:				Brand Name:	
41	Fly Ash ASTM C-618	Type:				Brand Name:	
42	GGBF Slab ASTM C-989	Type:				Brand Name:	
43	Water Reducing Admixture ASTM C-494	Type:				Brand Name:	
44	Other Admixtures	ASTM:		Type:		Brand Name:	
45		ASTM:		Type:		Brand Name:	
46							
47	The design concrete mix meets the criteria of the current Wisconsin Construction Specification 4, Concrete. (Date of Specification 4: _____).						
48							
49							
50							
51	Signature: _____						
52	Title: _____						
53							

AB—PROFILE VIEW

OWNER: LEDGEVIEW FARM'S, LLC

COUNTY: BROWN

BCLWCD

BROWN COUNTY LAND & WATER CONSERVATION DEPT.

Drawing Name

WI—006

Date

Sheet ___ of ___

Designed

Drawn

Checked

Approved

Date



Engineering Resources, Testing Solutions

REPORT OF LABORATORY ANALYSIS OF SOIL

Project: LEDGEVIEW FARMS, LLC
DE PERE, WISCONSIN
Client: Mr. (b) (6)(b) (6)
Ledgeview Farms, LLC
(b) (6)(b) (6)(b) (6)
De Pere, WI 54115
Date: **Revised December 10, 2015
RVT File No: G15-256
Copies: Mr. Dave Wetenkamp
Brown County LWCD
e)wetenkamp_dl@co.brown.wi.us

GENERAL:
Scope of Work: Perform Percent Material Passing the #200 Sieve, Atterberg Limits, Hydraulic Conductivity and Visual Classification of Soils on the submitted samples.
Date of Test: 11/4/15
Sampled By: I MacMillan of RVT
Soil Description: LEAN CLAY, with Sand, reddish-brown (CL)
**Technician: K Orthober / M Wisneski
Date Delivered: 11/4/15

RESULTS:
Test Method: ASTM D2487
ASTM D1140
ASTM D4318
ASTM D5084
Classification of Soils for Engineering Purposes
Percent Material Finer than the No 200 Sieve
Liquid Limit, Plastic Limit, and Plasticity Index of Soils
Hydraulic Conductivity Test

Sample Number	3256	Project Specifications
USCS Classification	CL	CL or CH
Percent Passing #200 Sieve (P200)	84	50% Minimum
Liquid Limit (LL)	44	
Plastic Limit (PL)	18	
Plasticity Index (PI)	26	12 Minimum
**Hydraulic Conductivity (cm/sec)	2.1 x 10 ⁻⁸	1 x 10 ⁻⁷ cm/sec Maximum

REMARKS:
The sample above meets project specifications. A portion of the sample will be held for 30 days after the date of this report and then will be discarded unless notified otherwise.

Respectfully Submitted,
River Valley Testing Corp.

SEE AB PLAN VIEW FOR TEST LOCATIONS



DENSITY TEST OF
COMPACTED FILL

Report Date: 11/5/2015
Test Method: ASTM D 6938

Client:
Ledgeview Farms, LLC
(b) (6)(b) (6)(b) (6)
De Pere, WI 54115

Project:
G15-256
Ledgeview Farms
(b) (6)(b) (6)(b) (6)
De Pere, WI

Test Results													
Test #	Retest Of	Test Date	Proctor ID	Method	Soil Classification	Optimum Moisture (%)	Maximum Dry Density (pcf)	In Place Moisture (%)	In Place Dry Density (pcf)	Probe Depth (in)	Percent Compaction	Min Comp. (%)	Remark
1		10/29/15	3256-proctor#1	A	CL	17.5	103.6	18.6	110.2	12	106	95	1S
2		10/29/15	3256-proctor#1	A	CL	17.5	103.6	15.6	103.1	12	100	95	1S
3		10/29/15	3256-proctor#1	A	CL	17.5	103.6	17.3	102.3	12	99	95	1S
4		10/29/15	3256-proctor#1	A	CL	17.5	103.6	18.3	104.5	12	101	95	1S
5		10/29/15	3256-proctor#1	A	CL	17.5	103.6	16.5	107.0	12	103	95	1S
6		10/29/15	3256-proctor#1	A	CL	17.5	103.6	19.7	102.6	12	99	95	1S
Test Information													
Test #	Test Location							Elevation	Reference	Gauge Make / Model / SN		Field Technician	
1	Pond Liner: GPS Coordinate: 534829.29N 112397.23E							0.0	Liner Surface	Troxler 3440 20649		Macmillan, Isaac	
2	Pond Liner: GPS Coordinate: 534852.16N 112319.16E							0.0	Liner Surface	Troxler 3440 20649		Macmillan, Isaac	
3	Pond Liner: GPS Coordinate: 534917.15N 112315.34E							0.0	Liner Surface	Troxler 3440 20649		Macmillan, Isaac	
4	Pond Liner: GPS Coordinate: 535017.77N 112315.32E							0.0	Liner Surface	Troxler 3440 20649		Macmillan, Isaac	
5	Pond Liner: GPS Coordinate: 535046.23N 112390.63E							0.0	Liner Surface	Troxler 3440 20649		Macmillan, Isaac	
6	Pond Liner: GPS Coordinate: 534985.13N 112465.96E							0.0	Liner Surface	Troxler 3440 20649		Macmillan, Isaac	
Remarks						Comments				Related Tests			
1S: Test results comply with specifications (Lab ASTM D698)						Tests are "Direct Transmission" (Method A) unless probe depth is noted as "Backscatter". Gauge calibration data on file with the testing agency.				Test #	Related Test #		Test Type

Sheet 1 of 1
Date 2016
WI-006
Drawing Name

BCLWCD
BROWN COUNTY LAND & WATER CONSERVATION DEPT.

AB-PICS/LINER TESTS

OWNER: LEDGEVIEW FARMS
COUNTY: BROWN

Designed DLW
Drawn
Checked
Approved
Date 2/16